


- NOTES:
- THIS DRAWING WAS COMPILED FROM INFORMATION PROVIDED BY WANZEK, UTILIZING INFORMATION FROM THE FOLLOWING FILE LIST.
    - CRM\_AvoidanceBuffer\_110813.SHX
    - USFWS\_WetEase\_1012.SHX
    - Wetlands\_Poly\_102314.SHX
    - Courtenay\_TurbineArrayRenumbering\_2015\_07\_15.SHX
    - Courtenay ALTA 150120.DWG
    - Courtenay\_CollectionRecordLines\_20161108.SHP
    - Courtenay\_AdditionalSurveyCorridor\_2015\_10\_07.kmz
  - THE AERIAL WAS OBTAINED BY ULTEIG.
    - CourtenayAerial\_NDStateplane\_HarrNAD83\_South\_IntlFt.SID

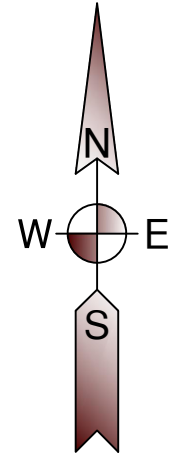

**RECORD DRAWING**  
DRAWINGS ARE BASED UPON  
CONSTRUCTION CONTRACTOR REDLINES  
WHICH HAVE NOT BEEN FIELD VERIFIED BY  
ENGINEER OF RECORD.

LEGEND	
	WIND TURBINE
	FEEDER 1
	FEEDER 2
	FEEDER 3
	FEEDER 4
	FEEDER 5
	FEEDER 6
	FEEDER 7
	FEEDER 8
	FIBER ROUTE
	SURVEYED CORRIDORS
	RIGHT OF WAY
	NON LEASED
	JUNCTION BOX
	CABLE SPLICE
	FIBER SPLICE
	MID SPAN GROUND
	ACCESS ROADS
	BORE LOCATION <b>RB X-X</b>

NO	REVISION	ZONE	DATE	BY	CHK	ENG	NO	REVISION	ZONE	DATE	BY	CHK	ENG	REFERENCE DRAWINGS		
A	90% SUBMITTAL		10/12/2015	MJ	JH	BG								DWG NO.	MANUFACTURER	DESCRIPTION
0	ISSUED FOR CONSTRUCTION		01/22/2016	AS	JH	BG										
1	REVISED KEY MAP		02/10/2016	CL	JH	BG										
2	RECORD DRAWING		12/05/2016	GP	JH	BG										

NORTHERN STATES POWER  
**COURTENAY WIND - COLLECTION SYSTEM**  
STUTSMAN COUNTY, NORTH DAKOTA

DWN: MJ	DATE:01/22/2016	CHK:	DATE:
ENG: BG	DATE:01/22/2016	CHK:	DATE:
PM: BD	DATE:01/22/2016	PROJ. NO: 121901101	
APVD:	DATE:	SCALE:NONE	

THIS MAP/DOCUMENT IS A TOOL TO ASSIST EMPLOYEES IN THE PERFORMANCE OF THEIR JOBS. YOUR PERSONAL SAFETY IS PROVIDED FOR BY USING SAFETY PRACTICES, PROCEDURES, AND EQUIPMENT AS DESCRIBED IN THE SAFETY TRAINING PROGRAMS AND MANUALS.

**ENERGY SUPPLY**  
ENGINEERING & CONSTRUCTION

**UNIT 0**  
FEEDER ROUTING DIAGRAM  
SECTION 09, T143N, R63W

**NH-271536-21**

REV  
2